


KEY PLAN

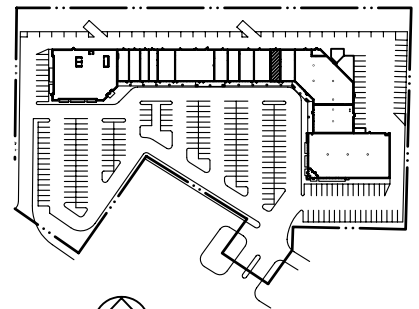

PLAN NORTH

## Suite 3023 - 935 RSF

07-08-09



Winther-Johnson-Robinson  
Architects+Designers

8175-B Lewis Road  
Golden Valley, Minnesota 55427  
Phone: 763-398-0452 Fax: 763-398-0455

## Coon Rapids Square

3005-3070 Coon Rapids Blvd.  
Coon Rapids, MN 55433

## Wellington

MANAGEMENT, INC.

1625 Energy Park Dr., Suite 100  
St. Paul, MN 55108  
Tel: 651-292-9844 Fax: 651-292-0072