


KEY PLAN

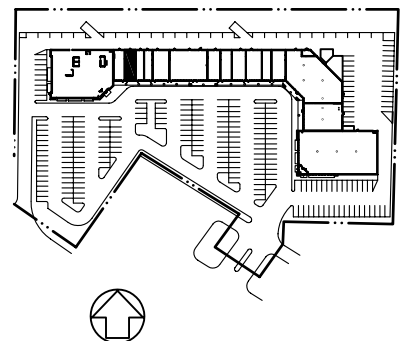

PLAN NORTH

Suite 3065 - 1,045 RSF

06-12-08



Winther-Johnson-Robinson
Architects-Designers

8175-B Lewis Road
Golden Valley, Minnesota 55427
Phone: 763-398-0452 Fax: 763-398-0455

Coon Rapids Square

3005-3070 Coon Rapids Blvd.

Coon Rapids, MN 55433

Wellington

MANAGEMENT, INC.

1625 Energy Park Dr., Suite 100
St. Paul, MN 55108
Tel: 651-292-9844 Fax: 651-292-0072