



Winter-Johnson-Robinson
Architects-Designers

8175-B Lewis Road
Golden Valley, Minnesota 55427
Phone: 763-944-4155
Fax: 763-944-4155

I hereby certify that the plans, specifications or contract documents prepared by me or under my direct supervision and that I am a duly registered architect under the laws of the State of Minnesota.

Date: _____ Reg. No. _____

4255 Parkway Place

Suite 1700-2100


Issues & Revisions:
Revision Date: _____

Sheet Title:
As-Built Plan


Location:
4955 Parkway Place

Project No.:
Scale: 1/8" = 1'-0"
Drawn By:
Approved:

AB1
OF
C COPYRIGHT DRAWING REVISION PRO. WARK

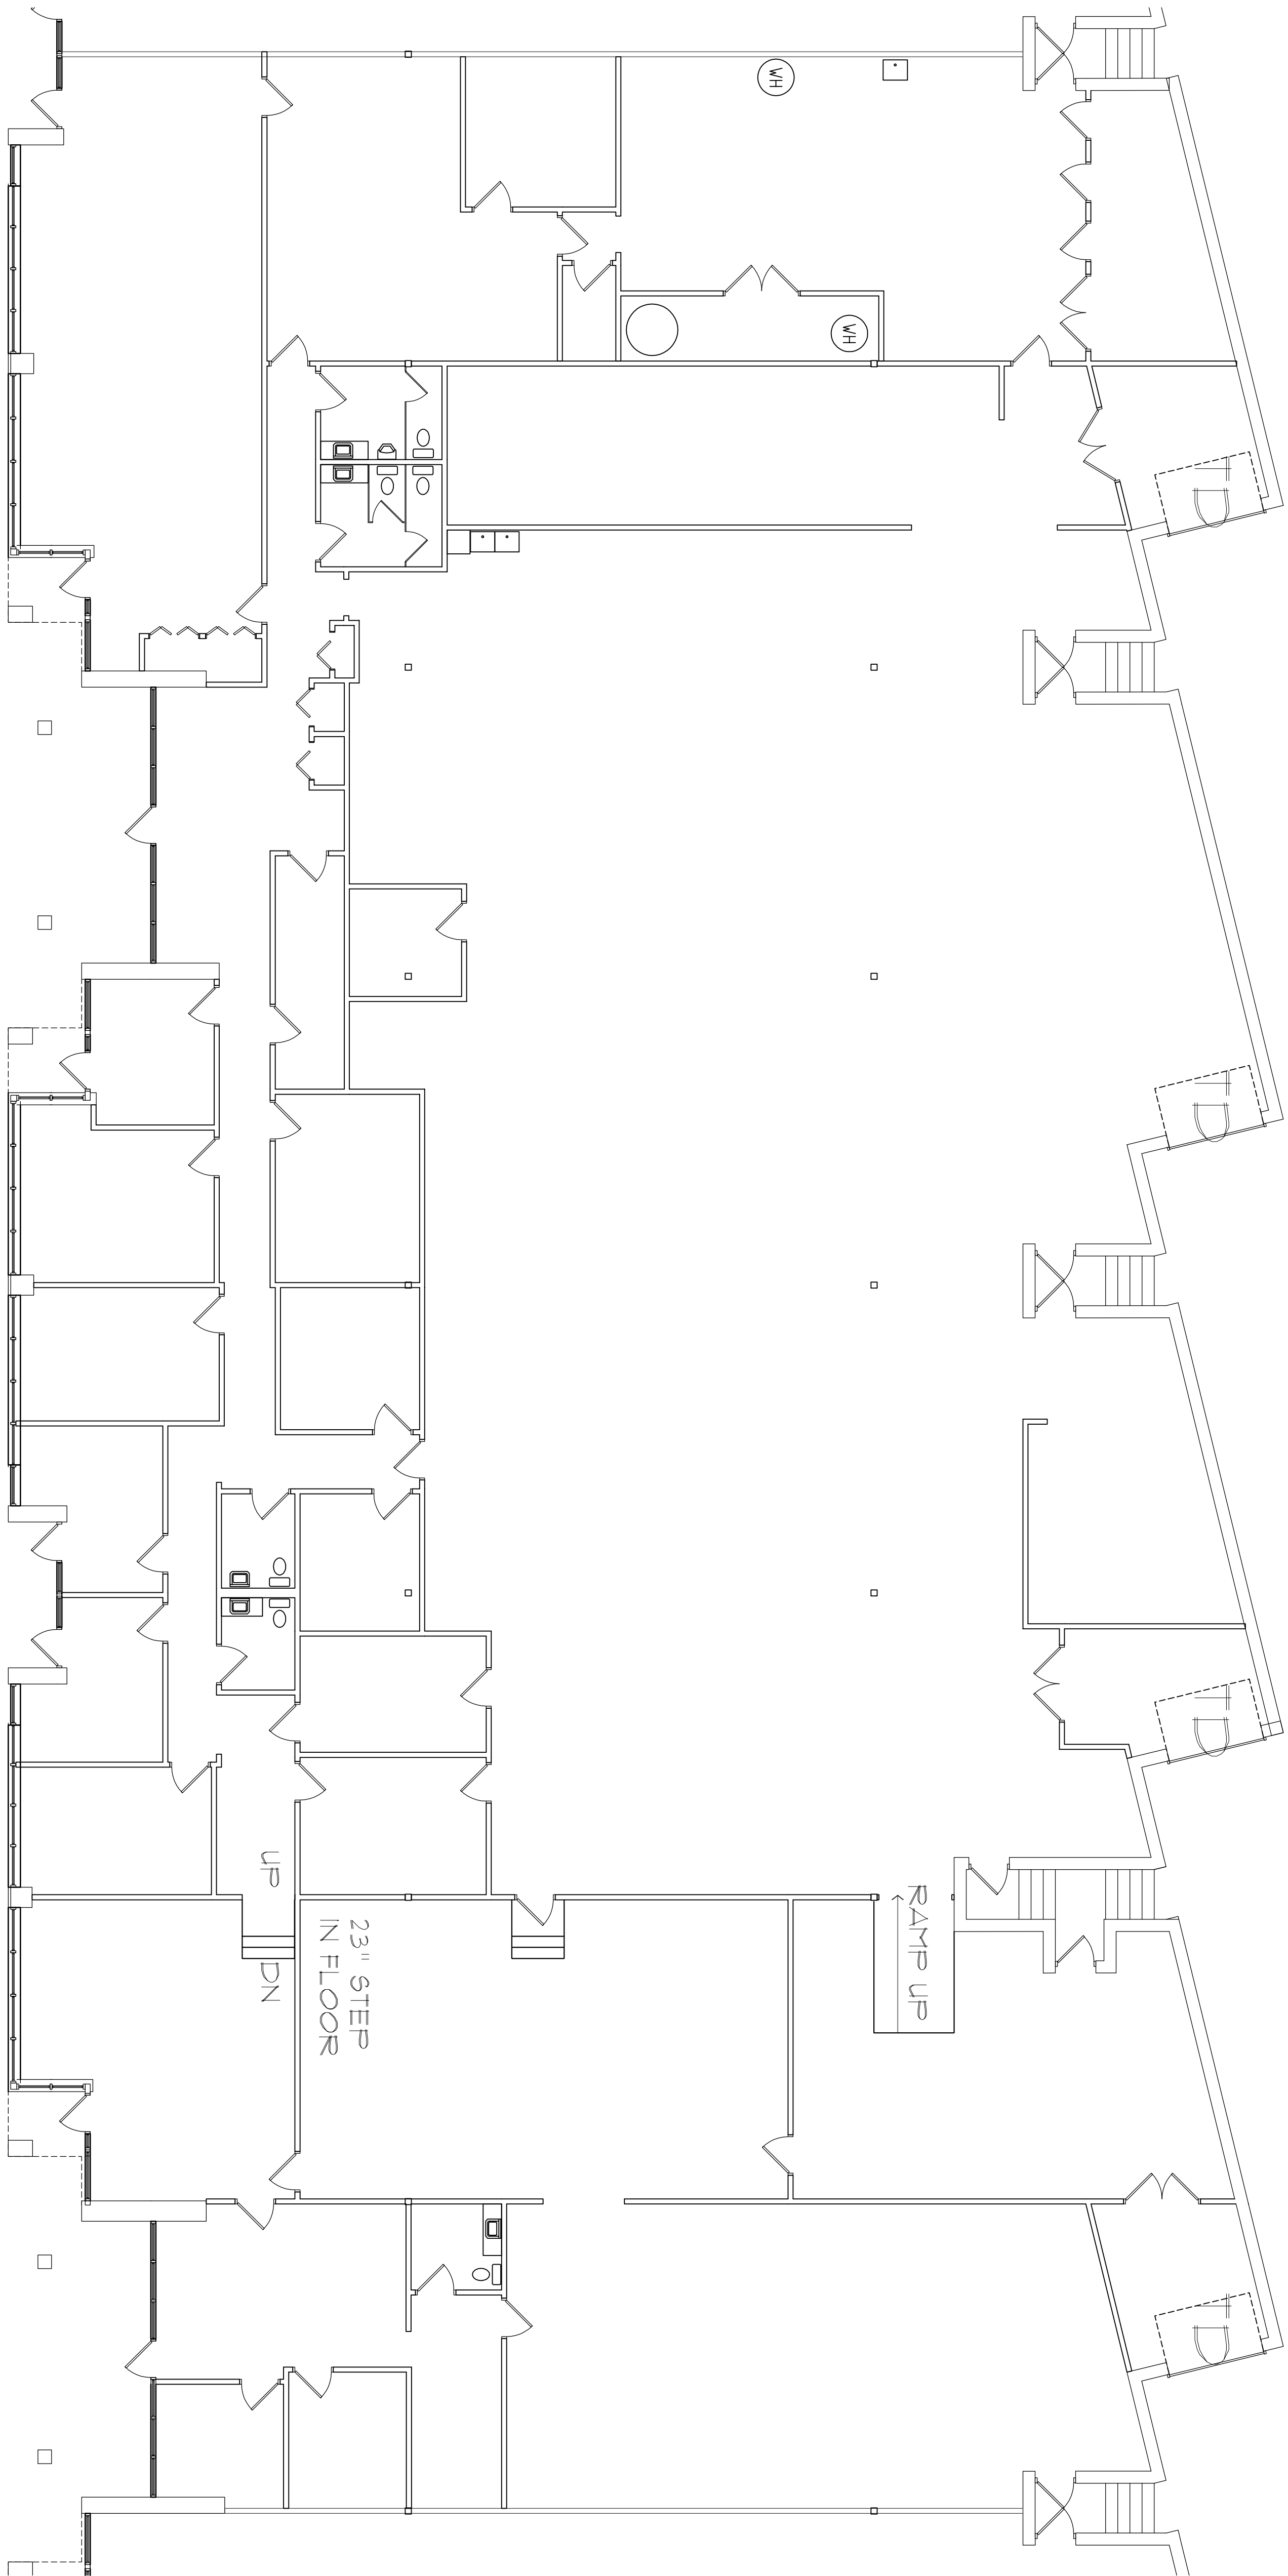

KEY PLAN

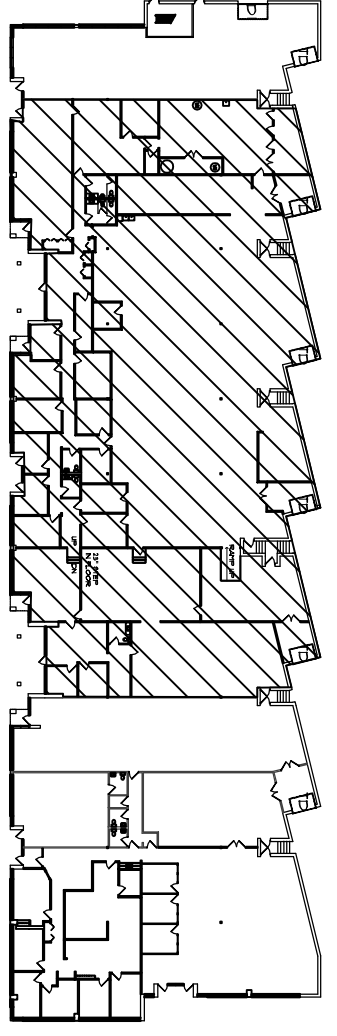

Suite 1700-2100

1/8" = 1'-0" 19,262 RSF