



KEY PLAN - 1ST FLOOR

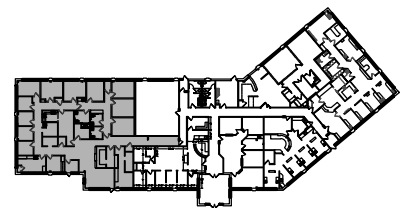

Suite 160 - 5,441 RSF

03-23-24

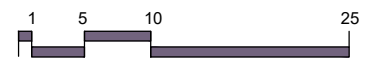

PREPARED BY WJR, INC.

March 23, 2024

NORTH



Winther-Johnson-Robinson
Architects-Designers
8175-B Lewis Road
Golden Valley, Minnesota 55427
Phone: 763-398-0452

Valley Creek Commons

8380 City Centre Drive
Woodbury, MN 55125



WELLINGTON
MANAGEMENT

Commercial Real Estate

Tel: 651-292-9844 Fax: 651-292-0072